

ICN: 2744
ABN: 93 807 596 843

Tom Price
(Head Office)
1 Stadium Road
Tom Price
Western Australia 6751

Postal Address:
PO Box 28
TOM PRICE WA 6751

Perth
(Administration Office)
Level 2
165 Adelaide Terrace
East Perth
Western Australia 6004

Postal Address:
PO Box 3167
East Perth, WA 6892

Contacts

P: 1800 486 252
F: (08) 9219 4555

Accounts:
accounts@gumala.com.au

General:
gac@gumala.com.au

Chairman:
Steven W. Dhu
Executive Officer:
Jahna Cedar
www.gumala.com.au

ATTENTION – ALL MEMBERS

YANDI BYPASS ROAD CLOSURE – NOTICE

Please be advised that the Yandi bypass road has been temporary closed.

Advanced notice caution signage was installed in February on major intersections and points of interest to alert road users to the upcoming changes (Refer to attached map for installation points). The road has now been closed and 'Road Closed' signs and windrows have been installed to prevent access through the construction area (indicated in yellow on the map attachment, Corktree bore South along Weeli Wolli Creek, 5b/5c to 5/5a).

The construction of the by-pass road will take approximately 6 months to construct and is scheduled to re-open late September 2017.

Safety of our members is our number one priority, so we need to ensure people are fully aware of the closure and active nature of the site.

If you have any queries regarding this matter – please do not hesitate to contact Ronwyn James in our Tom Price Office on 1800 486 252 or (08) 9188 4500.

RioTinto

Iron Ore (WA)

Road Signage Locations

Drawn: M Swabbs
Date: July 2016
Plan No: RDS0144 (Rev 1)
Proj: MCA04 (Zone 50)


Mariliana Station
Private Property
Sign moved to West of
Rail line

**No Road,
Sign not
installed**

LOCATION

MAP EXTENT

BHPIO Yandi
Yandicoogina
MAC
Hope Downs 1
West Angelas
SHIRE OF EAST PILBARA
Mount Whaleback
Hope Downs 4
Christmas Creek
Cloudbreak

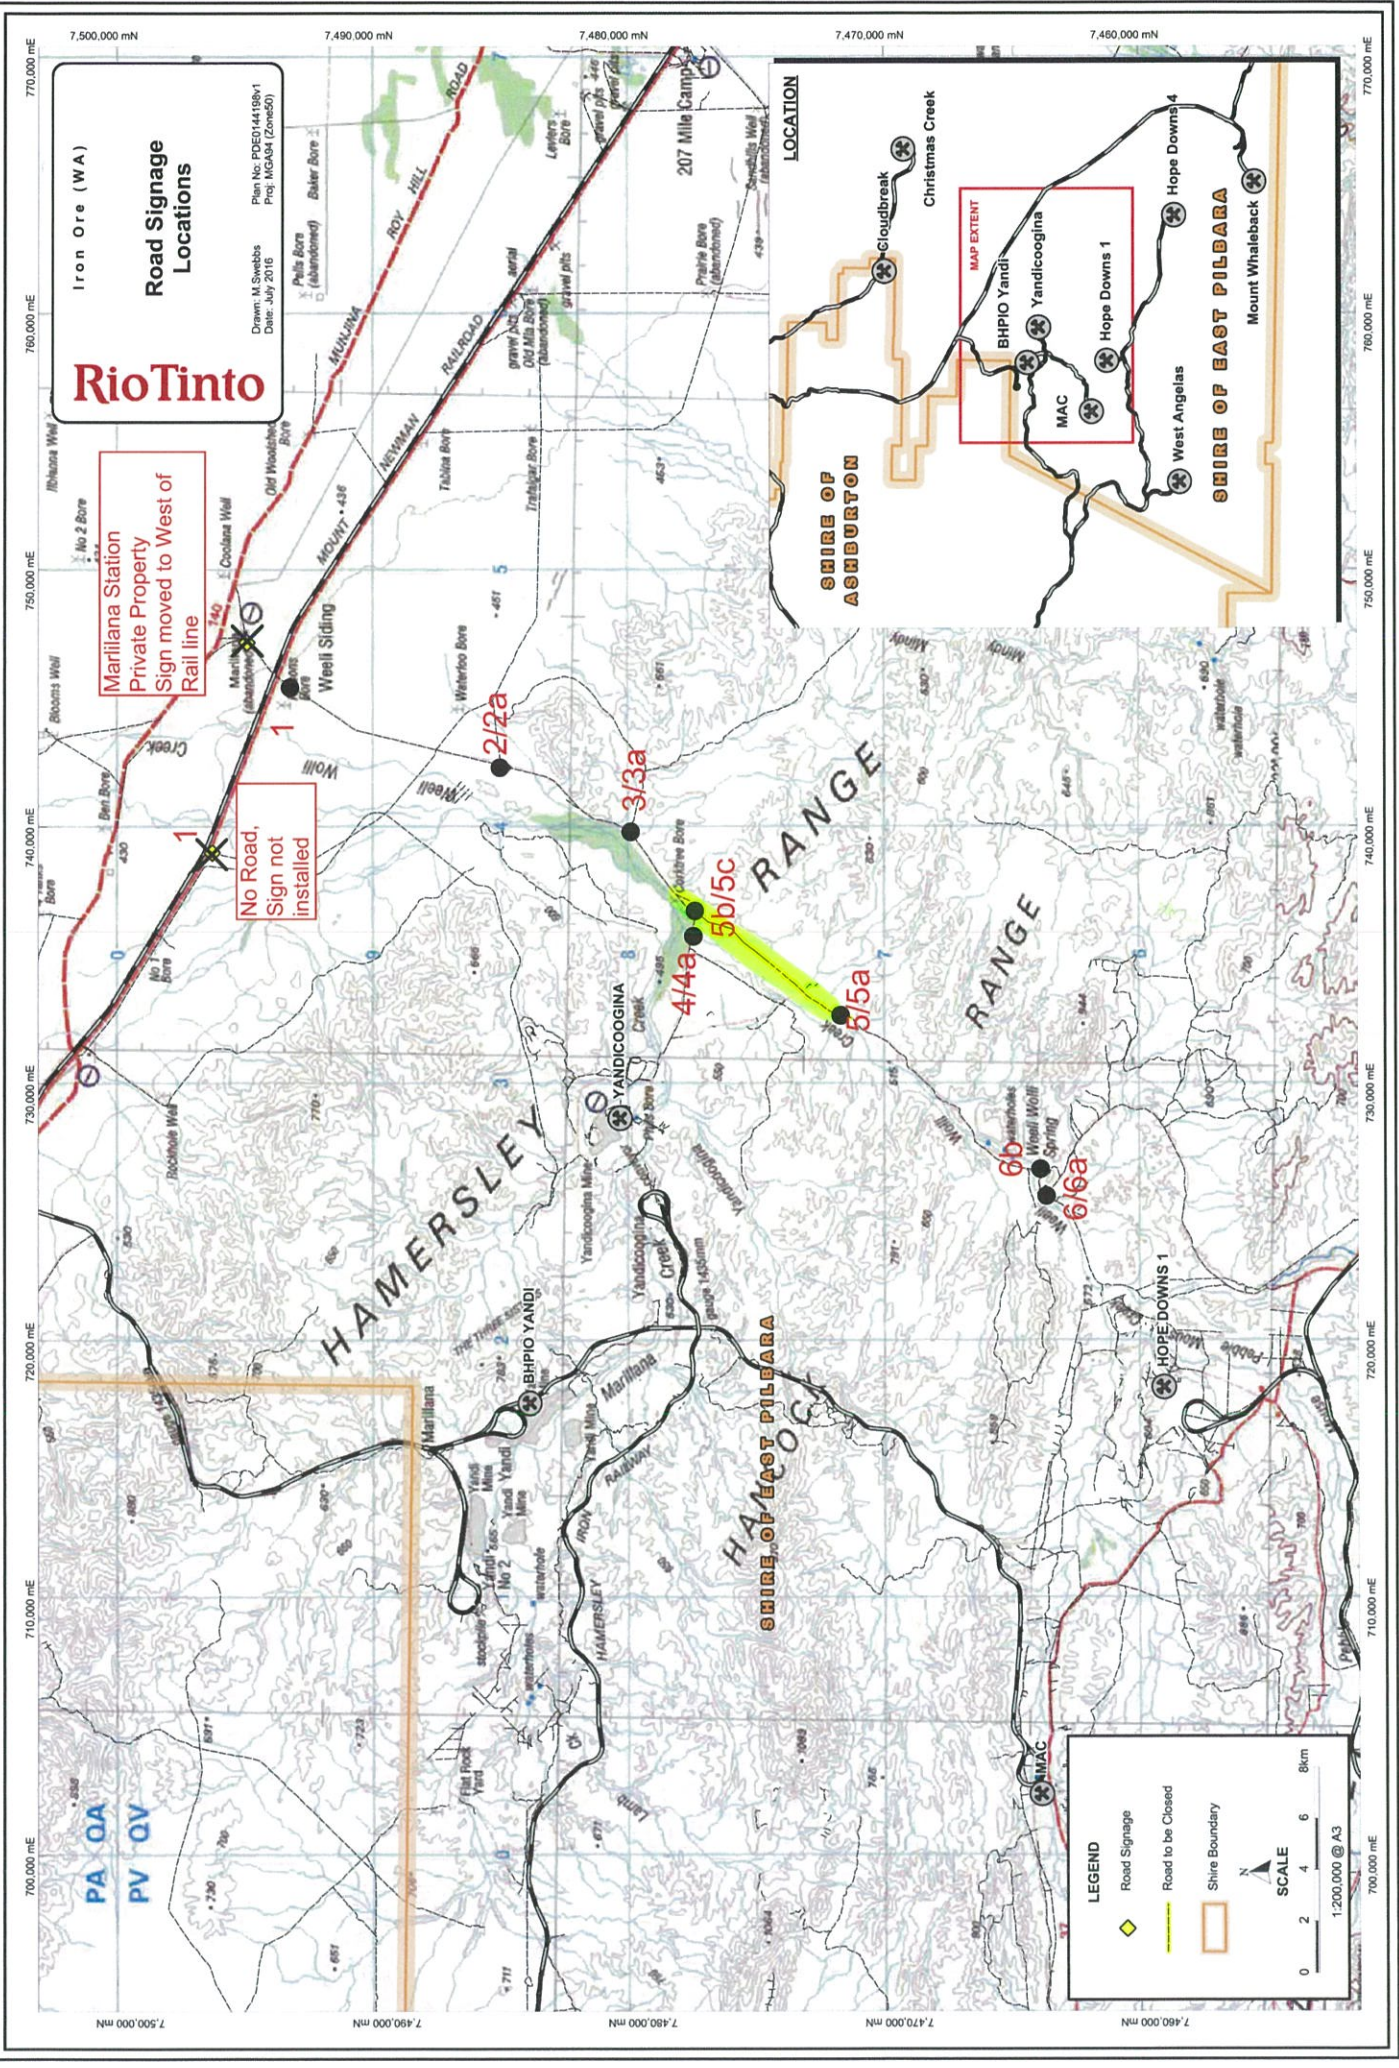

LEGEND

Road Signage

Road to be Closed

Shire Boundary

SCALE
0 2 4 6 8km
1:200,000 @ A3